

Appendix A Existing Topographical and Utility Surveys



SERVICE ABBREVIATIONS

(AC)	Assumed Connection	HV	High Voltage
HAB	Habit Box		


Although all reasonable effort has been made in searching available record drawings the completeness of the underground services information cannot be guaranteed.

Unless otherwise stated, drainage pipes are 100mm diameter.

LEGEND

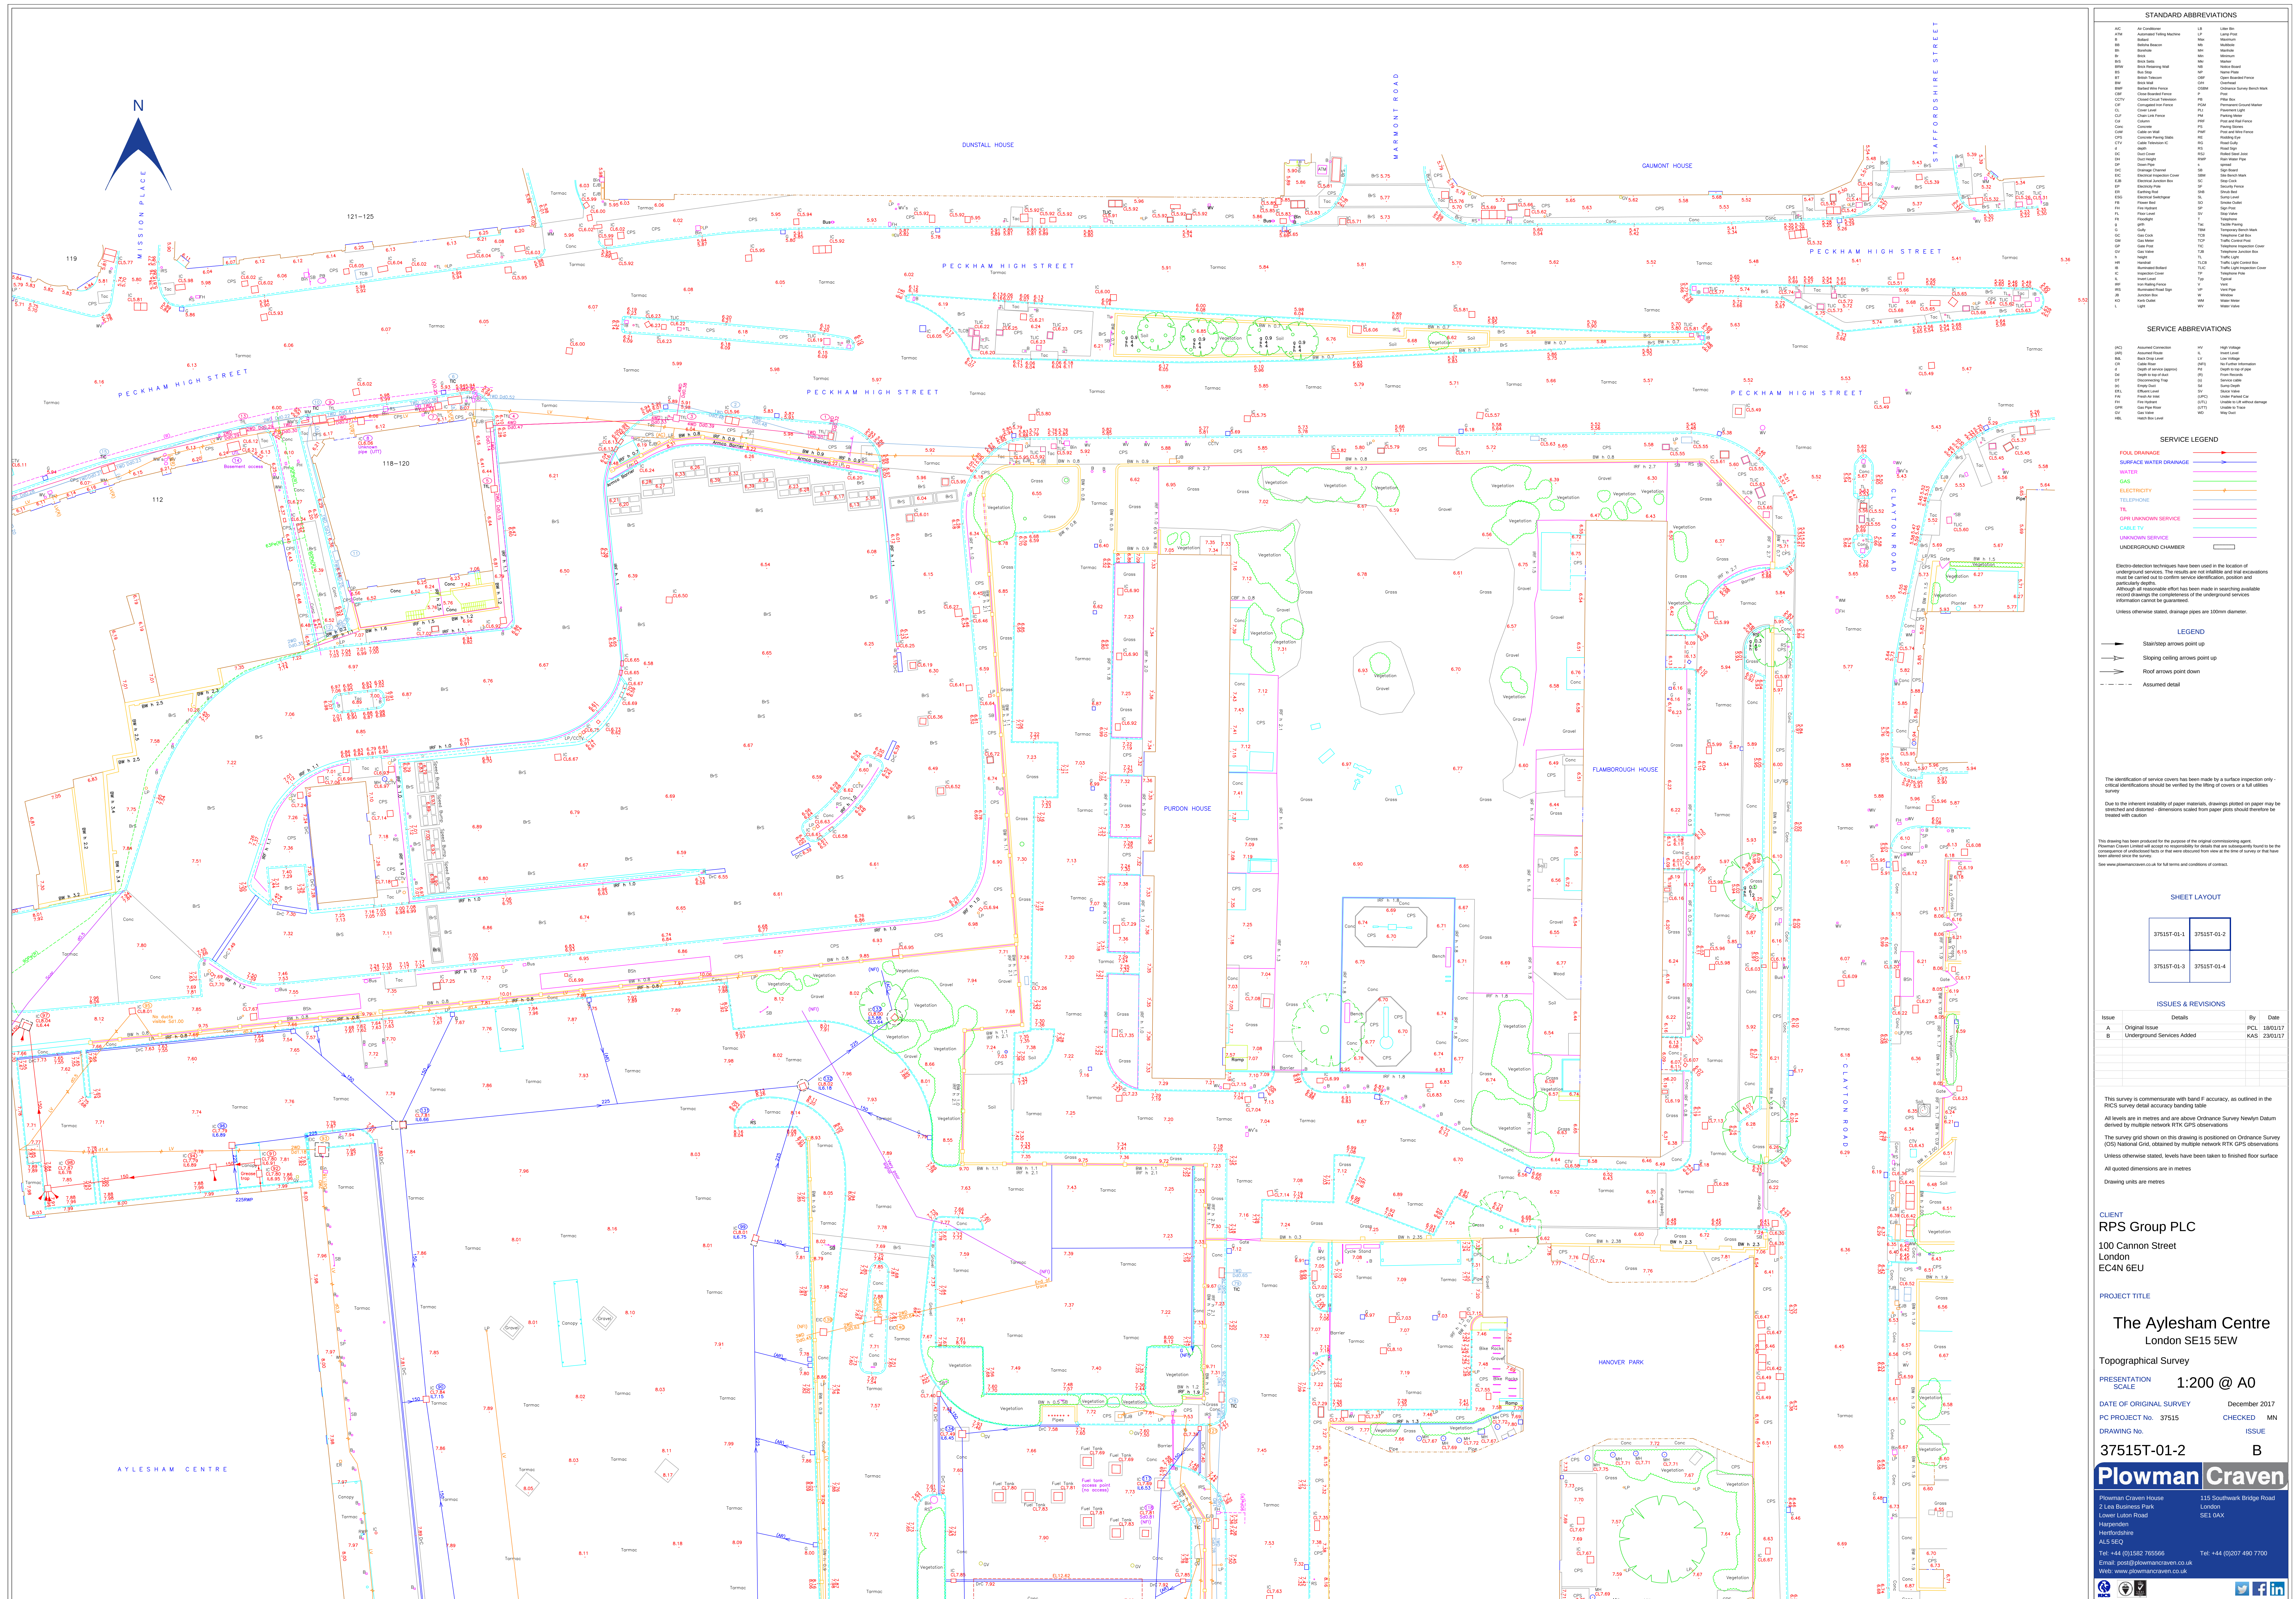
	Stair/step arrows point up
	Sloping ceiling arrows point up
	Roof arrows point down
	Assumed detail

This drawing has been produced for the purpose of the original commissioning agent. Ploverman Craven Limited will accept no responsibility for details that are subsequently found to be the consequence of undisclosed facts or that were obscured from view at the time of survey or that have been altered since the survey.

See www.plovermancraven.co.uk for full terms and conditions of contract.

ISSUES & REVISIONS			
Issue	Details	By	Date
A	Original Issue	PCL	18/01/17
B	Underground Services Added	KAS	23/01/17

CLIENT
RPS Group PLC
100 Cannon Street
London
EC4N 6EU

[illegible]

SERVICE ABBREVIATIONS

(AC)	Assumed Connection	HV	High Voltage
HA	Head Loss		

SERVICE LEGEND

- FOLK DRAINAGE
- SURFACE WATER DRAINAGE
- WATER
- GAS
- ELECTRICITY
- TELEPHONE
- TIL
- GPR UNKNOWN SERVICE
- CABLE TV
- UNKNOWN SERVICE

UNDERGROUND CHAMBER

The diagram shows a vertical list of service types on the left, each paired with a horizontal line of a specific color on the right. The services and their corresponding line colors are: Folk Drainage (red), Surface Water Drainage (blue), Water (purple), Gas (green), Electricity (orange), Telephone (light blue), TIL (pink), GPR Unknown Service (dark purple), Cable TV (cyan), and Unknown Service (magenta). Below these lines is a grey rectangular box labeled 'UNDERGROUND CHAMBER'. Some lines have additional symbols: a red arrow pointing right for Folk Drainage, a blue arrow pointing right for Surface Water Drainage, and a small orange lightning bolt for Electricity.

Electro-detection techniques have been used in the location of underground services. The results are not infallible and trial excavations must be carried out to confirm service identification, position and particularly depths.

Although all reasonable effort has been made in searching available record drawings the completeness of the underground services information cannot be guaranteed.

Underground details shown on plan are 100mm diameter

LEGEND

	Stair/step arrows point up
	Sloping ceiling arrows point up
	Roof arrows point down
	Assumed detail

Due to the inherent instability of paper materials, drawings plotted on paper may be stretched and distorted - dimensions scaled from paper plots should therefore be treated with caution

This drawing has been produced for the purpose of the original commissioning agent. Plowman Craven Limited will accept no responsibility for details that are subsequently found to be the consequence of undisclosed facts or that were obscured from view at the time of survey or that have been altered since the survey.

See www.plowmancraven.co.uk for full terms and conditions of contract.

SHEET LAYOUT

37515T-01-1	37515T-01-2
37515T-01-3	37515T-01-4

ISSUES & REVISIONS			
Issue	Details	By	Date
A	Original Issue	PCL	18/01/17
B	Underground Services Added	KAS	23/01/17

This survey is commensurate with band F accuracy, as outlined in the RICS survey detail accuracy banding table

All levels are in metres and are above Ordnance Survey Newlyn Datum derived by multiple network RTK GPS observations

The survey grid shown on this drawing is positioned on Ordnance Survey (OS) National Grid, obtained by multiple network RTK GPS observations

Unless otherwise stated, levels have been taken to finished floor surface

All quoted dimensions are in metres

Drawing units are metres

CLIENT
RPS Group PLC
100 Cannon Street
London
EC4N 6EU

PROJECT TITLE

The Aylesham Centre
London SE15 5EW

Topographical Survey

PRESENTATION SCALE 1:200 @ A0

DATE OF ORIGINAL SURVEY	December 2017
-------------------------	---------------

PC PROJECT No. 37515 CHECKED MN

DRAWING No.	ISSUE
-------------	-------

37515T-01-2	B
Plowman	Craven

Plowman Craven Plowman Craven House 2 Lea Business Park	115 Southwark Bridge Road London
--	-------------------------------------

Lower Luton Road
Harpenden
Hertfordshire
AL5 5EQ

Tel: +44 (0)1582 765566 Tel: +44 (0)207 490 7700

Email: post@plowmancraven.co.uk
Web: www.plowmancraven.co.uk
































SERVICE ABBREVIATIONS

(AC)	Assumed Connection	(HV)	High Voltage

Unless otherwise stated, drainage pipes are 100mm diameter.

	Stair/step arrows point up
	Sloping ceiling arrows point up
	Roof arrows point down
	Assumed detail

This drawing has been produced for the purpose of the original commissioning agent. Ploswin Craven Limited will accept no responsibility for details that are subsequently found to be the consequence of undisclosed facts or that were obscured from view at the time of survey or that have been altered since the survey.

See www.ploswincraven.co.uk for full terms and conditions of contract.

37515T-01-1	37515T-01-2
37515T-01-3	37515T-01-4

Issue	Details	By	Date
A	Original Issue	PCL	18/01/
B	Underground Services Added	KAS	23/01/

This survey is commensurate with band F accuracy, as outlined in the RCIS survey detail accuracy banding table

All levels are in metres and are above Ordnance Survey Newlyn Datum derived by multiple network RTK GPS observations

The survey grid shown on this drawing is positioned on Ordnance Survey (OS) National Grid, obtained by multiple network RTK GPS observations

Unless otherwise stated, levels have been taken to finished floor surface

All quoted dimensions are in metres

Drawing units are metres

CLIENT
RPS Group PLC
100 Cannon Street
London
EC4N 6EU

PROJECT TITLE

The Aylesham Centre
London SE15 5EW

Topographical Survey

PRESENTATION SCALE 1:200 @ A0

DATE OF ORIGINAL SURVEY December 2017

PC PROJECT No. 37515 CHECKED MN
DRAWING No. ISSUE

37515T-01-3	B
-------------	---

Plummer

Plowman Craver

Plowman Craven House 115 Southwark Bridge Road
2 Lea Business Park London

Lower Luton Road SE1 0AX
Harpenden
Hertfordshire


Web: www.plowman-craven.co.uk

